

Date: Friday, 2/23/2007 1:48:44 PM  
User: Kim Johnston

# Process Sheet

|                       |  |                  |                     |
|-----------------------|--|------------------|---------------------|
| Customer              | : CU-DAR001 Dart Helicopters Services  | Drawing Name     | : AFT TUBE ASSEMBLY |
| Job Number            | : 30931  |                  |                     |
| Estimate Number       | : 10699  |                  |                     |
| P.O. Number           | : <u>N/A</u>   | Part Number      | : D3391025          |
| This Issue            | : 2/23/2007  | S.O. No.         | : <u>N/A</u>        |
| Prsht Rev.            | : NC   | Drawing Number   | : D3391 REV E       |
| First Issue           | : <u>N/A</u>   | Project Number   | : N/A               |
| Previous Run          | : 30699  | Drawing Revision | : E                 |
|                       |  | Material         | : <u>N/A</u>        |
| Written By            | : <u>[Signature]</u>   | Due Date         | : 3/21/2007         |
| Checked & Approved By | : <u>[Signature]</u>   | Qty:             | 1 Um: Each          |
| Comment               | Est Rev: B 06-02-07 ECN773 dwg rev. D EC<br>Est Rev: C 06-03-28 Update Manufacturing Instructions<br>JLM |                  |                     |

## Additional Product

Job Number:



|         |                       |              |
|---------|-----------------------|--------------|
| Seq. #: | Machine Or Operation: | Description: |
|---------|-----------------------|--------------|

|     |          |                    |
|-----|----------|--------------------|
| 1.0 | D6014090 | ALUMINUM EXTRUSION |
|-----|----------|--------------------|



Comment: Qty.: 1.0000 f(s)/Unit Total: 1.0000 f(s)

ALUMINUM EXTRUSION

Pick:

|     |             |             |               |
|-----|-------------|-------------|---------------|
| Qty | Part Number | Description | Batch         |
| 1   | D6014-090   | Extrusion   | <u>B06546</u> |

Identify as D3391-3

2F 07/03/09

|     |            |                            |
|-----|------------|----------------------------|
| 2.0 | MORI SEIKI | MORI SEIKI CNC LATHE LARGE |
|-----|------------|----------------------------|



Comment: MORI SEIKI CNC LATHE LARGE

Turn as per Folio FA599 Rev: AA & Dwg D3391 Rev: E

2F 07/03/09

|     |     |  |
|-----|-----|--|
| 3.0 | QC2 | INSPECT PARTS AS THEY COME OFF MACHINE |
|-----|-----|--|



Comment: INSPECT PARTS AS THEY COME OFF MACHINE

2F 07/03/09

|     |       |                                |
|-----|-------|--------------------------------|
| 4.0 | HAAS1 | HAAS CNC VERTICAL MACHINING #1 |
|-----|-------|--------------------------------|



Comment: HAAS

1-Machine as per Folio FA 599 Rev: AA & Dwg D3391 Rev: E

2-Drill ( PILOT HOLE) aft cap holes per Dwg D3391 using DT8803

3-Deburr

JL 107/03/13

| W/O: |      | WORK ORDER CHANGES |    |      |     |                                     |                          |  |
|------|------|--------------------|----|------|-----|-------------------------------------|--------------------------|--|
| DATE | STEP | PROCEDURE CHANGE   | By | Date | Qty | Approval<br>Chief Eng /<br>Prod Mgr | Approval<br>QC Inspector |  |
|      |      |                    |    |      |     |                                     |                          |  |
|      |      |                    |    |      |     |                                     |                          |  |

Part No: \_\_\_\_\_ PAR #: \_\_\_\_\_ Fault Category: \_\_\_\_\_ NCR: Yes ☒ No ☐ DQA: ☒ Date: 07/04/04  
 QA: N/C Closed: \_\_\_\_\_ Date: \_\_\_\_\_

| NCR:     |      | WORK ORDER NON-CONFORMANCE (NCR)   |                             |   |                 |                           |                       |                          |
|----------|------|--|-----------------------------|---|-----------------|---------------------------|-----------------------|--------------------------|
| DATE     | STEP | Description of NC<br>Section A   | Corrective Action Section B |   |                 | Verification<br>Section C | Approval<br>Chief Eng | Approval<br>QC Inspector |
|          |      |  | Initial<br>Chief Eng        | Action Description<br>Chief Eng   | Sign &<br>Date  |                           |                       |                          |
| 07/03/13 | 4    | - dimension 3.300 $\pm$ .010 is 3.318<br>- dimension 3.520 $\pm$ .010 is 3.537 | Posian                      | API section was tested in mil tube 1530930. API tube is acceptable, the fit is very good. | J.L<br>07/03/13 | Posian                    | Posian                | Posian                   |
|          |      |  |                             |   |                 |                           |                       |                          |
|          |      |  |                             |   |                 |                           |                       |                          |

NOTE: Date & initial all entries

Date: Friday, 2/23/2007 1:48:44 PM  
User: Kim Johnston

## Process Sheet

Customer: CU-DAR001 Dart Helicopters Services

Drawing Name: AFT TUBE ASSEMBLY

Job Number: 30931

Part Number: D3391025

Job Number:



Seq. #:

Machine Or Operation:

Description :

5.0

QC2

INSPECT PARTS AS THEY COME OFF MACHINE



Comment: INSPECT PARTS AS THEY COME OFF MACHINE

JL 07/03/13

1

6.0

QC8

SECOND CHECK



Comment: SECOND CHECK

owl 07/03/13

1

7.0

BENDING

BENDING MACHINE



Comment: NC Bender

Form as per Dwg D3391 Using Bend Prog 3391025

DP

7-3-13

8.0

QC5

INSPECT WORK TO CURRENT STEP



Comment: INSPECT WORK TO CURRENT STEP

BE 7-3-14

9.0

LANDING GEAR 1

LANDING GEAR RESOURCE 1



Comment: LANDING GEAR RESOURCE 1

1-Open Aft cap pilot hole to .208" as per Dwg D3391

Pm 07-03-14

2-Drill Tube as per D3391 using DT8809 (HOLES MARKED "A" ONLY)

Pm 07-03-14

3-Drill and c' sink wearshoe holes as per Dwg D3391 Using DT8878(Mid Tube) & DT8217 Wearplate Jig

Pm 07-03-14

4-C'sink holes for float bag (4 holes per side) as per Dwg D3391

Pm 07-03-15

5-Deburr

Pm 07-03-15

Tools: rill

10.0

QC5

INSPECT WORK TO CURRENT STEP



Comment: INSPECT WORK TO CURRENT STEP

07/03/14

11.0

HAND FINISHING1

HAND FINISHING RESOURCE #1



Comment: HAND FINISHING RESOURCE #1

Acid etch and Alodine as per QSI 005 4.1

HS/m-h

07-03-20

| W/O: |      | WORK ORDER CHANGES |    |      |     |                                     |                          |  |
|------|------|--------------------|----|------|-----|-------------------------------------|--------------------------|--|
| DATE | STEP | PROCEDURE CHANGE   | By | Date | Qty | Approval<br>Chief Eng /<br>Prod Mgr | Approval<br>QC Inspector |  |
|      |      |                    |    |      |     |                                     |                          |  |
|      |      |                    |    |      |     |                                     |                          |  |

Part No: \_\_\_\_\_ PAR #: \_\_\_\_\_ Fault Category: \_\_\_\_\_ NCR: Yes No DQA: \_\_\_\_\_ Date: \_\_\_\_\_

QA: N/C Closed: \_\_\_\_\_ Date: \_\_\_\_\_

| NCR: |      | WORK ORDER NON-CONFORMANCE (NCR) |                             |  |                                 |                           |                       |                          |
|------|------|----------------------------------|-----------------------------|--|---------------------------------|---------------------------|-----------------------|--------------------------|
| DATE | STEP | Description of NC<br>Section A   | Corrective Action Section B |  |                                 | Verification<br>Section C | Approval<br>Chief Eng | Approval<br>QC Inspector |
|      |      |                                  | Initial<br>Chief Eng        |  | Action Description<br>Chief Eng |                           |                       |                          |
|      |      |                                  |                             |  |                                 |                           |                       |                          |
NOTE: Date & initial all entries

Date: Friday, 2/23/2007 1:48:44 PM  
User: Kim Johnston

## Process Sheet

Customer: CU-DAR001 Dart Helicopters Services

Drawing Name: AFT TUBE ASSEMBLY

Job Number: 30931

Part Number: D3391025

Jgb Number:



Seq. #:

Machine Or Operation:

Description :

12.0

POWDER COATING

POWDER COATING



103 141



Comment: POWDER COATING

Powder Coat White Gloss (Ref: 4.3.5.1) as per QSI 005 4.3

FL

07-03-29 ①

13.0

QC3

INSPECT POWDER COAT/CHEMICAL CONVERSION



①

Comment: INSPECT POWDER COAT/CHEMICAL CONVERSION

M-L

07/03/29

14.0

NAS1330C3KB166

INSERT



Comment: Qty.: 8.0000 Each(s)/Unit Total : 8.0000 Each(s)

INSERT

Pick:

Qty Part Number Description Batch

8 NAS1330C3KB166 Insert M100732.

15.0

HAND FINISHING1

HAND FINISHING RESOURCE #1



Comment: HAND FINISHING RESOURCE #1

Install Inserts as per dwg

FL

07/03/29 ①

16.0

QC5

INSPECT WORK TO CURRENT STEP



Comment: INSPECT WORK TO CURRENT STEP

M 07 03 30

①

17.0

AESS10KB366

INSERT



Comment: Qty.: 14.0000 Each(s)/Unit Total : 14.0000 Each(s)

Insert

Pick:

Qty Part Number Description Batch

14 AESS10KB366 Insert M103758

18.0

AESS10KB266

INSERT



Comment: Qty.: 2.0000 Each(s)/Unit Total : 2.0000 Each(s)

INSERT

Pick:

Qty Part Number Description Batch

2 AESS10KB266 Insert M17905

or NAS1330C3KB266

FL

07/03/29 ①

| W/O: |      | WORK ORDER CHANGES |    |      |     |                                     |                          |  |
|------|------|--------------------|----|------|-----|-------------------------------------|--------------------------|--|
| DATE | STEP | PROCEDURE CHANGE   | By | Date | Qty | Approval<br>Chief Eng /<br>Prod Mgr | Approval<br>QC Inspector |  |
|      |      |                    |    |      |     |                                     |                          |  |
|      |      |                    |    |      |     |                                     |                          |  |

Part No: \_\_\_\_\_ PAR #: \_\_\_\_\_ Fault Category: \_\_\_\_\_ NCR: Yes No DQA: \_\_\_\_\_ Date: \_\_\_\_\_

QA: N/C Closed: \_\_\_\_\_ Date: \_\_\_\_\_

| NCR: |      | WORK ORDER NON-CONFORMANCE (NCR) |                             |  |                                 |                           |                       |                          |
|------|------|----------------------------------|-----------------------------|--|---------------------------------|---------------------------|-----------------------|--------------------------|
| DATE | STEP | Description of NC<br>Section A   | Corrective Action Section B |  |                                 | Verification<br>Section C | Approval<br>Chief Eng | Approval<br>QC Inspector |
|      |      |                                  | Initial<br>Chief Eng        |  | Action Description<br>Chief Eng |                           |                       |                          |
|      |      |                                  |                             |  |                                 |                           |                       |                          |
**NOTE:** Date & initial all entries

Date: Friday, 2/23/2007 1:48:44 PM  
User: Kim Johnston

## Process Sheet

Customer: CU-DAR001 Dart Helicopters Services

Drawing Name: AFT TUBE ASSEMBLY

Job Number: 30931

Part Number: D3391025

Job Number:



Seq. #:

Machine Or Operation:

Description :

19.0

AESS10KB316

INSERT



Comment: Qty.: 2.0000 Each(s)/Unit Total : 2.0000 Each(s)

INSERT

Pick:

| Qty | Part Number       | Description | Batch  |
|-----|-------------------|-------------|--------|
| 2   | AESS10KB316       | Insert      | m17905 |
|     | or NAS1330C3KB316 |             |        |

20.0

D2646

Aft Cap



Comment: Qty.: 1.0000 Each(s)/Unit Total : 1.0000 Each(s)

Aft Cap

Pick:

| Qty | Part Number | Description | Batch  |
|-----|-------------|-------------|--------|
| 1   | D2646       | Aft Cap     | B30119 |

21.0

AN3C4A

BOLT



Comment: Qty.: 2.0000 Each(s)/Unit Total : 2.0000 Each(s)

Bolt

Pick:

| Qty | Part Number | Description | Batch   |
|-----|-------------|-------------|---------|
| 2   | AN3C4A      | Bolt        | M103691 |

22.0

AN960C10L

washer



Comment: Qty.: 2.0000 Each(s)/Unit Total : 2.0000 Each(s)

Inventory

Pick:

| Qty | Part Number | Description | Batch   |
|-----|-------------|-------------|---------|
| 2   | AN960C10L   | Washer      | M103691 |

23.0

NAS1515H3L

WASHER



Comment: Qty.: 2.0000 Each(s)/Unit Total : 2.0000 Each(s)

WASHER

Pick:

| Qty | Part Number | Description | Batch   |
|-----|-------------|-------------|---------|
| 2   | NAS1515H3L  | Washer      | M103641 |

m.h 07/03/31

| W/O: |      | WORK ORDER CHANGES |    |      |     |                                     |                          |  |
|------|------|--------------------|----|------|-----|-------------------------------------|--------------------------|--|
| DATE | STEP | PROCEDURE CHANGE   | By | Date | Qty | Approval<br>Chief Eng /<br>Prod Mgr | Approval<br>QC Inspector |  |
|      |      |                    |    |      |     |                                     |                          |  |
|      |      |                    |    |      |     |                                     |                          |  |

Part No: \_\_\_\_\_ PAR #: \_\_\_\_\_ Fault Category: \_\_\_\_\_ NCR: Yes No DQA: \_\_\_\_\_ Date: \_\_\_\_\_

QA: N/C Closed: \_\_\_\_\_ Date: \_\_\_\_\_

| NCR: |      | WORK ORDER NON-CONFORMANCE (NCR) |                             |                                 |                |                           |                       |                          |
|------|------|----------------------------------|-----------------------------|---------------------------------|----------------|---------------------------|-----------------------|--------------------------|
| DATE | STEP | Description of NC<br>Section A   | Corrective Action Section B |                                 |                | Verification<br>Section C | Approval<br>Chief Eng | Approval<br>QC Inspector |
|      |      |                                  | Initial<br>Chief Eng        | Action Description<br>Chief Eng | Sign &<br>Date |                           |                       |                          |
|      |      |                                  |                             |                                 |                |                           |                       |                          |
**NOTE:** Date & initial all entries



Date: Friday, 2/23/2007 1:48:44 PM  
User: Kim Johnston

## Process Sheet

Customer: CU-DAR001 Dart Helicopters Services

Drawing Name: AFT TUBE ASSEMBLY

Job Number: 30931

Part Number: D3391025

Job Number:



Seq. #:

Machine Or Operation:

Description :

24.0

HAND FINISHING1

HAND FINISHING RESOURCE #1



Comment: SMALL & MEDIUM FAB RESOURCE 1

1-Install inserts as per Dwg D3391

2-Install Aft Cap as per Dwg D3391

A/R Sikaflex-241/-291

Sikaflex expiry date:

M163497

07/10

M-R 07/03/31

①

25.0

QC5

INSPECT WORK TO CURRENT STEP



Comment: INSPECT WORK TO CURRENT STEP

Joelou@

26.0

PACKAGING 1

PACKAGING RESOURCE #1



Comment: PACKAGING RESOURCE #1

Identify and Stock

Location:

PPP

B30360

07/14/04

27.0

QC21

FINAL INSPECTION/W/O RELEASE



Comment: FINAL INSPECTION/W/O RELEASE

07/14/04

Job Completion



U 87-04-04

| W/O: |      | WORK ORDER CHANGES |    |      |     |                                     |                          |  |
|------|------|--------------------|----|------|-----|-------------------------------------|--------------------------|--|
| DATE | STEP | PROCEDURE CHANGE   | By | Date | Qty | Approval<br>Chief Eng /<br>Prod Mgr | Approval<br>QC Inspector |  |
|      |      |                    |    |      |     |                                     |                          |  |
|      |      |                    |    |      |     |                                     |                          |  |






Part No: \_\_\_\_\_ PAR #: \_\_\_\_\_ Fault Category: \_\_\_\_\_ NCR: Yes No DQA: \_\_\_\_\_ Date: \_\_\_\_\_

QA: N/C Closed: \_\_\_\_\_ Date: \_\_\_\_\_

| NCR: |      | WORK ORDER NON-CONFORMANCE (NCR) |                                |  |                                 |                           |                       |                          |
|------|------|----------------------------------|--------------------------------|--|---------------------------------|---------------------------|-----------------------|--------------------------|
| DATE | STEP | Description of NC<br>Section A   | Corrective Action<br>Section B |  |                                 | Verification<br>Section C | Approval<br>Chief Eng | Approval<br>QC Inspector |
|      |      |                                  | Initial<br>Chief Eng           |  | Action Description<br>Chief Eng |                           |                       |                          |
|      |      |                                  |                                |  |                                 |                           |                       |                          |
NOTE: Date & initial all entries



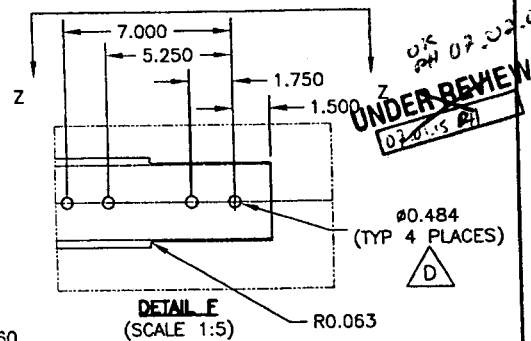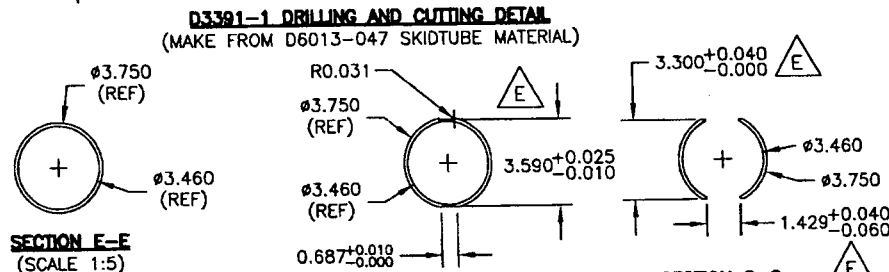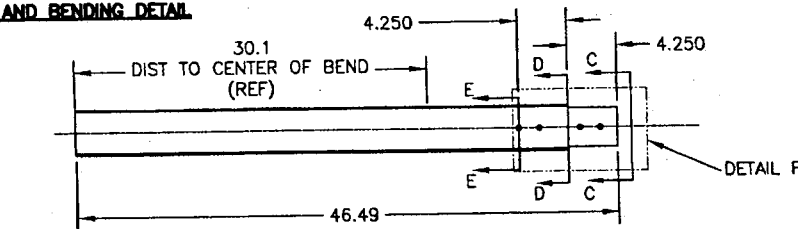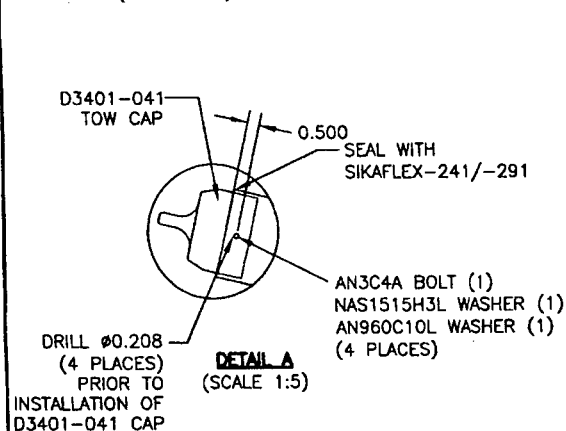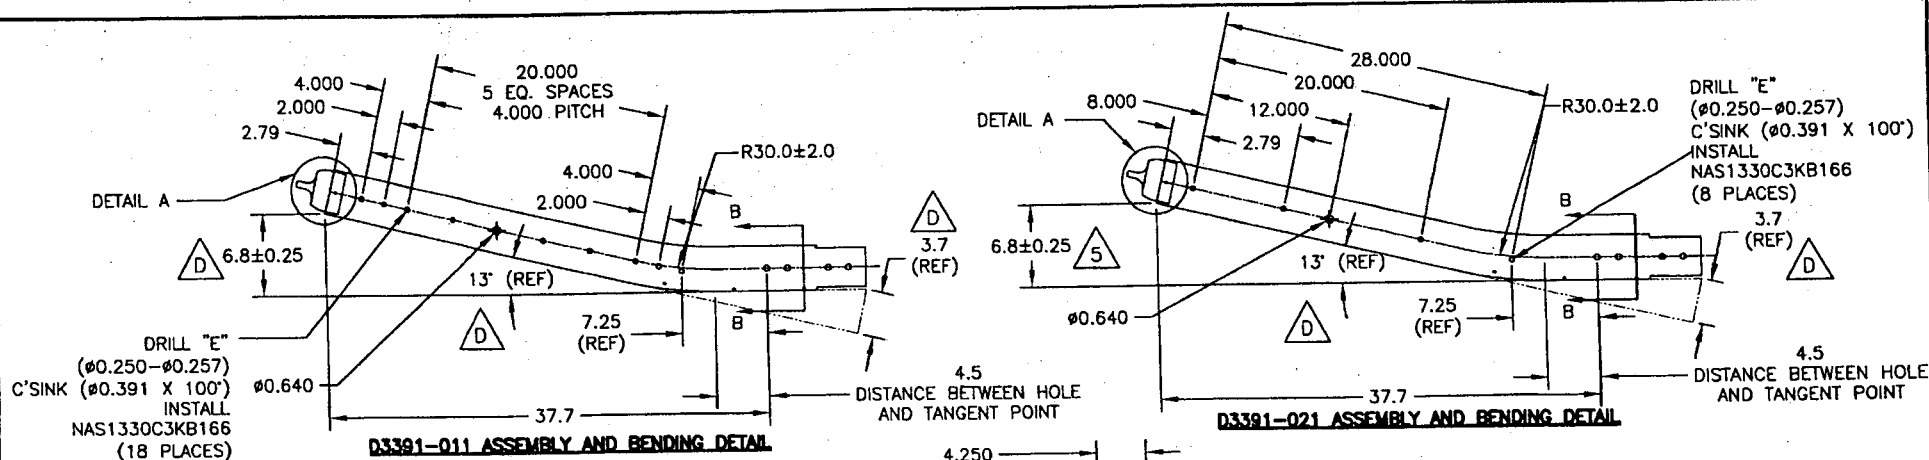

# **D3391-011/-021 FWD TUBE ASSEMBLY PARTS LIST**


| QTY - 011 | QTY - 021 | PART NUMBER    | DESCRIPTION       |
|-----------|-----------|----------------|-------------------|
| X         | X         | D3391-011      | FWD TUBE ASSEMBLY |
|           |           | D3391-021      | FWD TUBE ASSEMBLY |
| 1         | 1         | D8C13-047      | FWD TUBE          |
| 1         | 1         | D3401-041      | TOW CAP           |
| 4         | 4         | AN3C4A         | BOLT              |
| 4         | 4         | NAS1515H3L     | WASHER            |
| 4         | 4         | AN960C10L      | WASHER            |
| 24        | 14        | NAS1330C3KB166 | INSERT            |

5 DRILL "E"  
(Ø0.250-Ø0.257)  
C'SINK (Ø0.391 X 100")  
INSTALL  
NAS1330C3KB166  
(6 PLACES)



**DESIGN** PH **DRAWN BY** PH **DART** **DART AEROSPACE USA, INC.**  
PORT HADLOCK, MA

**CHECKED** # **APPROVED** # **DRAWING NO.** D3391 **REV. E**  
**DATE** 06.04.25 **TITLE** 412 FLOAT SKIDTUBE **SHEET 2 OF 5**  
**SCALE** 1:10

UNCONTROLLED COPY  
SUBJECT TO AMENDMENT  
WITHOUT NOTICE  
WORK ORDER  
NO. 1110931

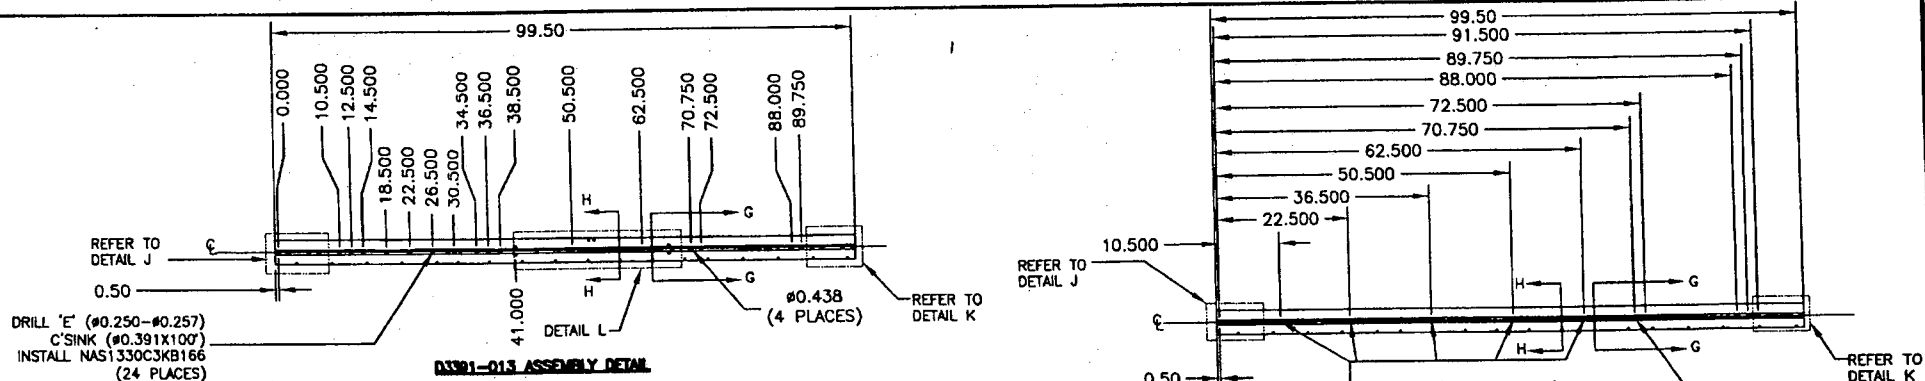


RELEASED  
06.05.01

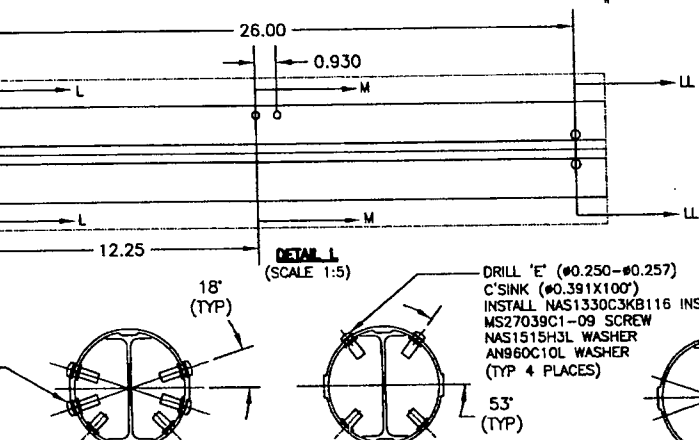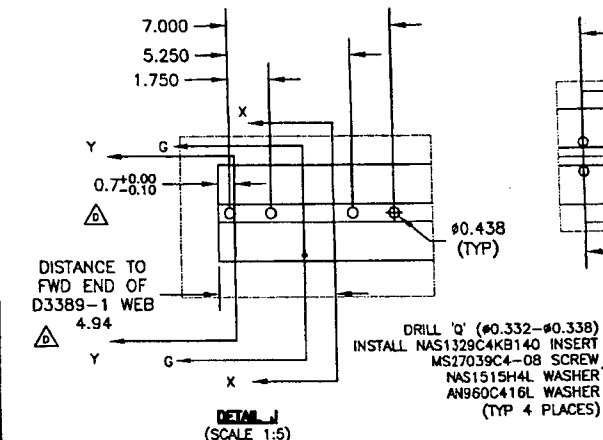

**D3391-013/-023 MID TUBE ASSEMBLY PARTS LIST**

| QTY - 013 | QTY - 023 | PART NUMBER    | DESCRIPTION       |
|-----------|-----------|----------------|-------------------|
| X         |           | D3391-013      | MID TUBE ASSEMBLY |
|           | X         | D3391-023      | MID TUBE ASSEMBLY |
| 1         | 1         | D2500-1-100    | EXTRUSION         |
| 1         | 1         | D3389-1        | WEB               |
| 24        | 20        | NAS1330C3KB116 | INSERT            |
| 24        | 10        | NAS1330C3KB166 | INSERT            |
| 4         |           | NAS1329C4KB140 | INSERT            |
| 4         |           | NAS1515H3L     | WASHER            |
| 4         |           | AN980C10L      | WASHER            |
| 4         |           | NAS1515H4L     | WASHER            |
| 4         |           | AN960C416L     | WASHER            |
| 4         |           | MS27039C1-08   | SCREW             |
| 4         |           | MS27039C4-08   | SCREW             |

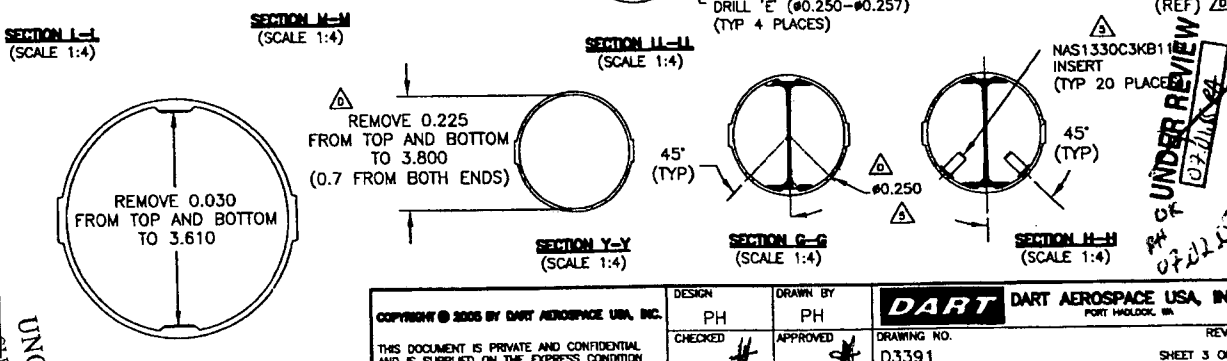

**D3391-013/-023 MID TUBE ASSEMBLY**

1) MATERIAL: MAKE FROM D2500-1-100 EXTRUSION

2) INSTALL D3389-1 WEB TO OUTER TUBE USING SIKAFLEX-241/-291 PER QSI 01515


UNCONTROLLED COPY  
ENGINEERING  
RETURN TO  
SHOP COPY  
NO. 30431  
SUBJECT TO AMENDMENT  
WITHOUT NOTICE  
WORK ORDER

**Copyright © 2005 by DART Aerospace USA, Inc.**


THIS DOCUMENT IS PRIVATE AND CONFIDENTIAL AND IS SUPPLIED ON THE EXPRESS CONDITION THAT IT IS NOT TO BE USED FOR ANY PURPOSE OR COPIED OR COMMUNICATED TO ANY OTHER PERSON WITHOUT WRITTEN PERMISSION FROM DART AEROSPACE USA, INC.

|                  |                             |  |
|------------------|-----------------------------|--|
| DESIGN<br>PH     | DRAWN BY<br>PH              | <b>DART</b> DART AEROSPACE USA, INC.<br>PORT HADLOCK, MA |
| CHECKED<br>#     | APPROVED<br>#               | DRAWING NO.<br>D3391                                     |
| DATE<br>06.04.25 | TITLE<br>412 FLOAT SKIDTUBE | REV. E<br>SHEET 3 OF 5<br>SCALE<br>1:20                  |


UNDER REVIEW  
07.22.07

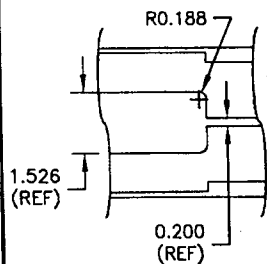


VIEW BB-BB  
(SCALE 1:3)

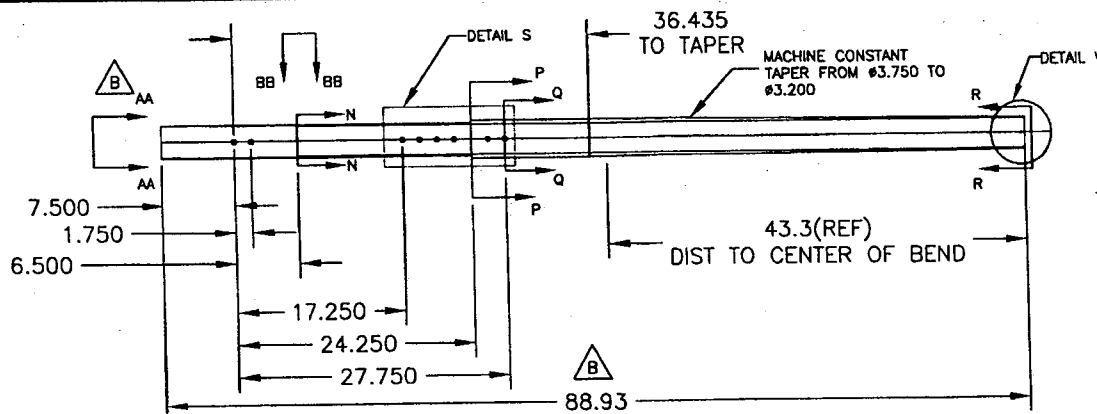


D3391-3 AFT DRILLING AND CUTTING DETAIL  
(MAKE FROM D6014-090 SKIDTUBE MATERIAL)

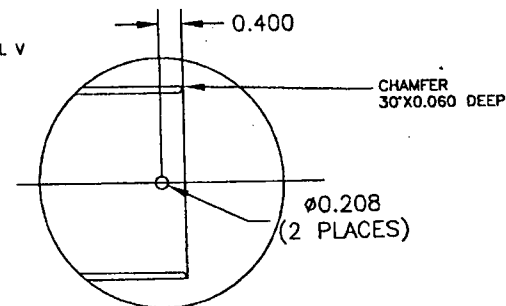


DETAIL V  
(SCALE 1:2)

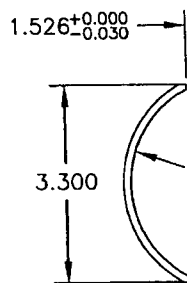


SECTION AA-AA  
(SCALE 1:2)

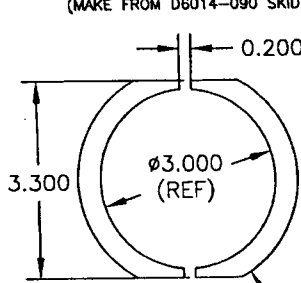


SECTION N-N  
(SCALE 1:2)

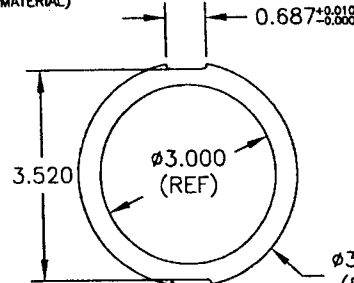


SECTION P-P  
(SCALE 1:2)

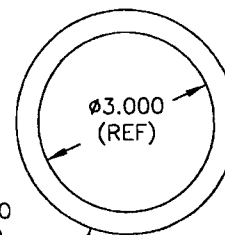


SECTION Q-Q  
(SCALE 1:2)

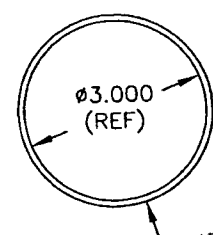

SECTION R-R  
(SCALE 1:2)

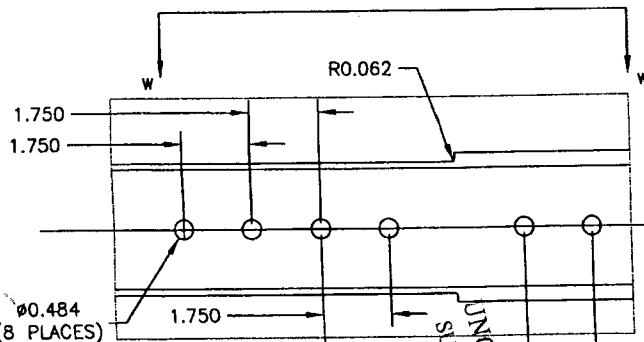

DETAIL S  
(SCALE 1:3)

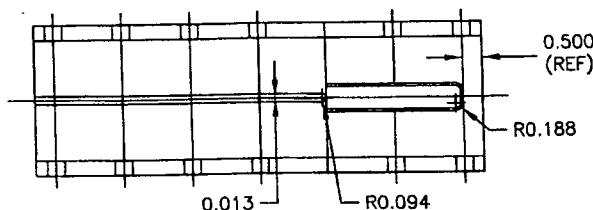

VIEW W-W  
(SCALE 1:3)

08 07.02.07  
UNDER REVIEW  
07.01.15 011

RELEASED





26.05.03

COPYRIGHT © 2005 BY DART AEROSPACE USA, INC.

THIS DOCUMENT IS PRIVATE AND CONFIDENTIAL AND IS SUPPLIED ON THE EXPRESS CONDITION THAT IT IS NOT TO BE USED FOR ANY PURPOSE OR COPIED OR COMMUNICATED TO ANY OTHER PERSON WITHOUT WRITTEN PERMISSION FROM DART AEROSPACE USA, INC.

|         |          |          |                    |  |
|---------|----------|----------|--------------------|--|
| DESIGN  | PH       | DRAWN BY | PH                 | <b>DART</b> DART AEROSPACE USA, INC.<br>PORT HADLOCK, WA |
| CHECKED | PH       | APPROVED | PH                 | DRAWING NO.<br>D3391                                     |
| DATE    | 06.04.25 | TITLE    | 412 FLOAT SKIDTUBE | REV. E<br>SHEET 4 OF 5<br>SCALE<br>1:12                  |

NO. 5.28  
WORK ORDER  
30931  
STOP COPY  
RETURN TO  
ENGINEERING  
UNCONTROLLED COPY  
SUBJECT TO AMENDMENT  
WITHOUT NOTICE

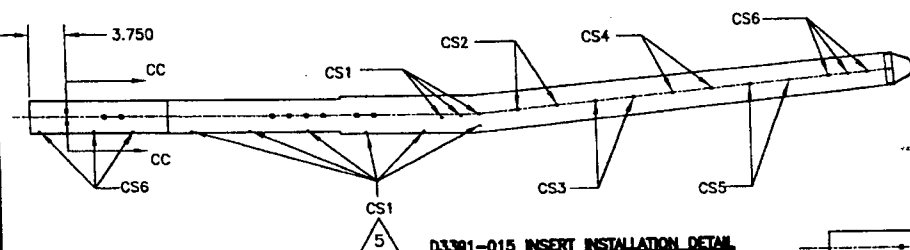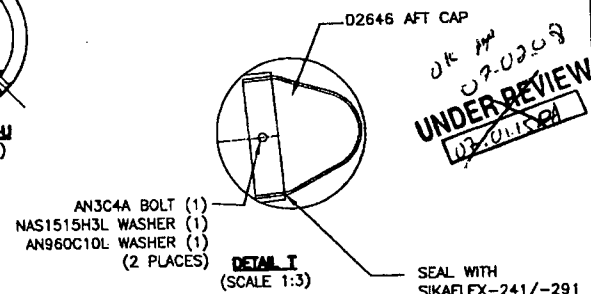
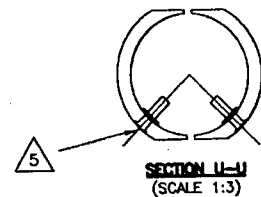
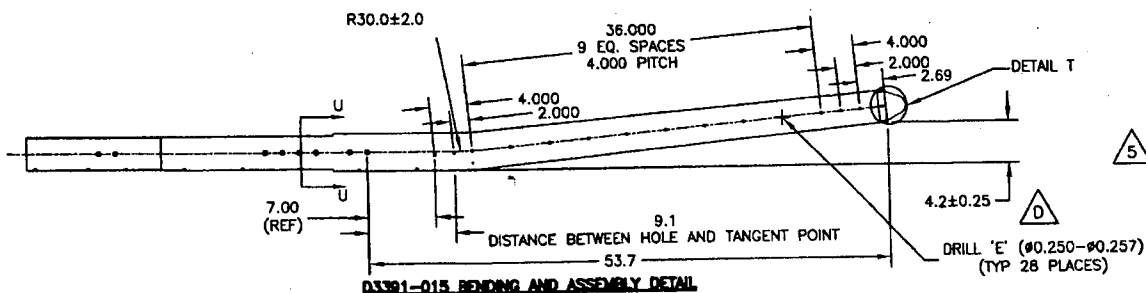


C'SINK AND INSTALL AESS10KBXXX AND/OR NAS1330C3KBXXX IN HOLES MARKED CS1-CS6 AS FOLLOWS

| HOLES MARKED | QTY | D3391-015 | QTY | D3391-025 | C'SINK | P/N            |
|--------------|-----|-----------|-----|-----------|--------|----------------|
| CS1          | 18  |           | 14  |           | Ø0.425 | AESS10KB396    |
| CS2          | 2   |           |     |           | Ø0.391 | AESS10KB396    |
| CS3          | 2   |           | 2   |           | Ø0.391 | NAS1330C3KB316 |
| CS4          | 2   |           | 2   |           | Ø0.391 | NAS1330C3KB266 |
| CS5          | 2   |           |     |           | Ø0.391 | NAS1330C3KB216 |
| CS6          | 12  |           | 8   |           | Ø0.391 | NAS1330C3KB166 |

#### D3391-015/-025 AFT TUBE ASSEMBLY PARTS LIST

| QTY - 015 | QTY - 025 | PART NUMBER    | DESCRIPTION       |
|-----------|-----------|----------------|-------------------|
| X         |           | D3391-015      | AFT TUBE ASSEMBLY |
|           | X         | D3391-025      | AFT TUBE ASSEMBLY |
| 1         | 1         | D6014-090      | AFT TUBE          |
| 1         | 1         | D2646          | AFT CAP           |
| 18        | 14        | AESS10KB396    | INSERT            |
| 4         | 2         | NAS1330C3KB316 | INSERT            |
| 4         | 2         | NAS1330C3KB266 | INSERT            |
| 4         |           | NAS1330C3KB216 | INSERT            |
| 12        | 8         | NAS1330C3KB166 | INSERT            |
| 4         |           | NAS1330C4KB151 | INSERT            |
| 2         | 2         | AN3C4A         | BOLT              |
| 2         | 2         | NAS1515H3L     | WASHER            |
| 2         | 2         | AN960C10L      | WASHER            |

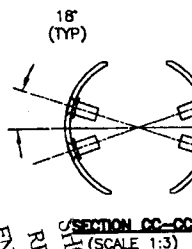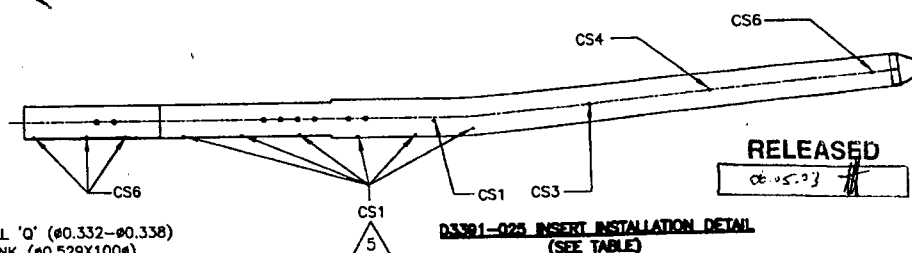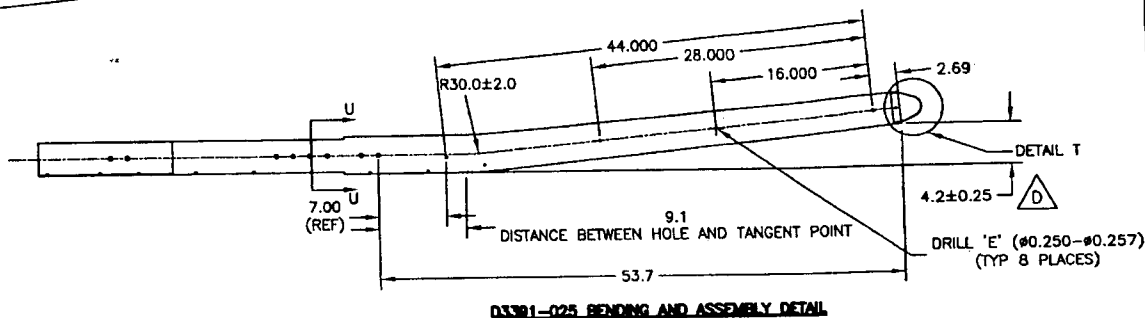

DRILL 'O' (Ø0.332-Ø0.338)  
C'SINK (Ø0.529X100#)  
NAS1330C4KB151 INSERT (1)  
(4 PLACES)

COPYRIGHT © 2005 BY DART AEROSPACE USA, INC.

THIS DOCUMENT IS PRIVATE AND CONFIDENTIAL AND IS SUPPLIED ON THE EXPRESS CONDITION THAT IT IS NOT TO BE USED FOR ANY PURPOSE OR COPIED OR COMMUNICATED TO ANY OTHER PERSON WITHOUT WRITTEN PERMISSION FROM DART AEROSPACE USA, INC.

|         |          |          |                    |  |
|---------|----------|----------|--------------------|--|
| DESIGN  | PH       | DRAWN BY | PH                 | <b>DART</b> DART AEROSPACE USA, INC.<br>PORT HADLOCK, OH |
| CHECKED |          | APPROVED |                    | DRAWING NO.<br>D3391                                     |
| DATE    | 06.04.25 | TITLE    | 412 FLOAT SKIDTUBE | REV. E<br>SHEET 5 OF 5<br>SCALE<br>1:12                  |

UNCONTROLLED COPY  
ENGINEERING  
RETURN TO  
SHOP COPY  
NO. 130813  
MARK ORDER  
SUBJECT TO AGREEMENT  
WITHOUT NOTICE

RELEASED

06-05-03

07-02-03  
UNDER REVIEW  
03-01-04

|                                   |        |                      |
|-----------------------------------|--------|----------------------|
| DART AEROSPACE LTD                |        | Work Order: 30931    |
| Description: Float Skidtube (412) |        | Part Number: D3391-3 |
| Inspection Dwg: D3391             | Rev: E | Page 1 of 1          |

### FIRST ARTICLE INSPECTION CHECKLIST

☒ First Article ☐ Prototype

| Drawing Dimension | Tolerance                | Actual Dimension | Accept | Reject | Method of Inspection | Comments |
|-------------------|--------------------------|------------------|--------|--------|----------------------|----------|
| 14.000            | +/-0.010                 | 14.000           | ✓      |        |                      |          |
| 3.500             | +/-0.010                 | 3.500            | ✓      |        |                      |          |
| 88.93             | +/-0.030                 | 88.93            | ✓      |        |                      |          |
| 44.995            | +/-0.030                 | 45.00            | ✓      |        |                      |          |
| 3.200             | +/-0.010                 | 3.210            | ✓      |        |                      |          |
| 1.526             | +0.000/-0.030            | 1.520            | ✓      |        |                      |          |
| 0.200             | +/-0.010                 | .205             | ✓      |        |                      |          |
| 7.500             | +/-0.010                 | 7.499            | ✓      |        |                      |          |
| 27.750            | +/-0.010                 | 27.750           | ✓      |        | m-tape               |          |
| 31.750            | +/-0.010                 | 31.750           | ✓      |        | "                    |          |
| 35.250            | +/-0.010                 | 35.250           | ✓      |        | "                    |          |
| 0.400             | +/-0.010                 |                  |        |        |                      |          |
| <del>0.200</del>  | <del>+0.005/-0.001</del> |                  |        |        |                      |          |
| 3.300             | +/-0.010                 | 3.318            | ✓      |        |                      |          |
| 0.200             | +/-0.010                 | .205             | ✓      |        |                      |          |
| 3.520             | +/-0.010                 | 3.537            | ✓      |        |                      |          |
| 0.687             | +0.010/-0.000            | .689             | ✓      |        |                      |          |
| R0.062            | +/-0.010                 | 1.062            | ✓      |        |                      |          |
| Ø0.484            | +0.005/-0.001            | .486             | ✓      |        |                      |          |
|                   |                          |                  |        |        |                      |          |
|                   |                          |                  |        |        |                      |          |
|                              |                          |                     |     |
|------------------------------|--------------------------|---------------------|-----|
| Measured by: <i>AS/BC/SL</i> | Audited by: <i>AS/BC</i> | Prototype Approval: | N/A |
| Date: 07/03/09               | Date: 07/03/13           | Date:               | N/A |

| Rev | Date     | Change                  | Revised by | Approved |
|-----|----------|-------------------------|------------|----------|
| A   | 06.04.24 | New Issue P/O D3391-025 | KJ/JLM     |          |
| B   | 06.06.19 | Dwg revision update     | KJ/JLM     |          |